


319474.20
7357031.14
MGA Zone 56

- GENERAL NOTES**
- These plans have been prepared as an As Constructed drawing for the Gladstone Regional Council and should not be used for any other purpose.
 - All surface and underground information has been located by field survey by Capricorn Survey Group during construction.
 - As this plan is presented in digital computer format no responsibility is accepted by Capricorn Survey Group for any alterations, amendments or additions to the plan. This note is an integral part of the plan.
 - Types and classes of underground services are as per engineering design drawings by Worley Parsons Pty Ltd unless noted otherwise.
 - Coordinate origin from PSM157203 and PSM177580
Adopted origin coordinates MGA Zone 56
PSM177594 East 319612.40 North 7357047.42
PSM157198 East 319608.91 North 7357409.05
 - AHD D from PSM95145 with adopted level of RL 57.996

WATER MAINS LEGEND

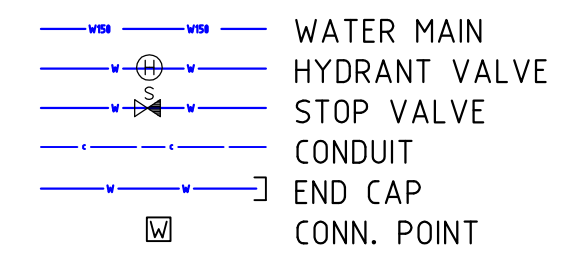

- WATER SUPPLY PIPE DIMENSIONS AND CLASSES**
- 100 & 150 DIAMETER LINES- uPVC CLASS 16
 - SERVICE CONDUITS POSITIONS AND ROAD CROSSINGS, HAVE BEEN SURVEYED AT THE LOCATIONS INDICATED BY THE CONTRACTOR.

This information, as supplied by Capricorn Survey Group is an accurate representation of the works as constructed and the information is suitable for use by Council and others.

Signed Date

Registered Professional Engineer

Name Registration No.



CSG
capricorn survey group

4/32 Chapple Street POBox 490
Gladstone QLD 4680
T 07 4972 9144 F 07 4972 1885
gladstone@capsurvey.com.au
R.B.N 59 419 394 235

PRINCIPAL

**Peet No 112
Pty Ltd**

PROJECT

**AS CONSTRUCTED
INFORMATION**

VANTAGE ESTATE
STAGE 1
Sheet 1 of 2

REAL PROPERTY DESCRIPTION

Lot No: 1-7,43-71,80-90,903
Plan: SP233796
Map Ref.: 9150-32114
Parish: Auckland
County: Clinton
L.A.: Gladstone R. C.
Locality: New Auckland

REVISIONS	DATE	INITIALS
A- Original Issue	11/11/10	DES

SOURCE DATA	FILE REF:	2987	
	VERSION:	63	
	DATA DISK:	GX	
	DATE:	09-11-10	
	DRAFTING	FILE REF:	G2987-63
		DATE:	10-11-2010

SURVEYED: CSG

DRAWN: D.E.S.

QUALITY CH'D:

DATE: 11-11-2010

DATUM

HORIZONTAL
MGA Zone 56

VERTICAL
AHD

SCALE

1:500 @ A1

AUTHORISED BY **DATE**

DIRECTOR

JOB NO. **REV.**

G2987-63 Water A

CSG

capricorn survey group

4/32 Chapple Street POBox 490
Gladstone QLD 4680
T 07 4972 9144 F 07 4972 1885
gladstone@capicornsurvey.com.au
R.B.N 59 419 394 233

PRINCIPAL

**Peet No 112
Pty Ltd**

PROJECT

**AS CONSTRUCTED
INFORMATION**
VANTAGE ESTATE
STAGE 1
Sheet 2 of 2

REAL PROPERTY DESCRIPTION

Lot No: 1-7,43-71,80-90,903
Plan: SP233796
Map Ref.: 9150-32114
Parish: Auckland
County: Clinton
L.A.: Gladstone R. C.
Locality: New Auckland

REVISIONS

REVISIONS	DATE	INITIALS
A- Original Issue	11/11/10	DES

FILE REF:	2987
SURVEY VERSION:	63
DATA DISK:	GX
DATE:	09-11-10
DRAFTING FILE REF:	G2987-63
DATA DISK:	Server
DATE:	10-11-2010

SURVEYED: CSG

DRAWN: D.E.S.

QUALITY CH'D:

DATE: 11-11-2010

DATUM	HORIZONTAL
	MGA Zone 56
VERTICAL	AHD

SCALE
1:500@A1

AUTHORISED BY _____ **DATE** _____

DIRECTOR _____ **REV.** _____

G2987-63 Water A

GENERAL NOTES

These plans have been prepared as an As Constructed drawing for the Gladstone Regional Council and should not be used for any other purpose.

All surface and underground information has been located by field survey by Capricorn Survey Group during construction.

As this plan is presented in digital computer format no responsibility is accepted by Capricorn Survey Group for any alterations, amendments or additions to the plan. This note is an integral part of the plan.

Types and classes of underground services are as per engineering design drawings by Worley Parsons Pty Ltd unless noted otherwise.

Coordinate origin from PSM157203 and PSM177580
Adopted origin coordinates MGA Zone 56
PSM177594 East 319612.40 North 7357047.42
PSM157198 East 319608.91 North 7357409.05
AHD D from PSM95145 with adopted level of RL 57.996


WATER MAINS LEGEND

- WATER MAIN
- HYDRANT VALVE
- STOP VALVE
- CONDUIT
- END CAP
- CONN. POINT

WATER SUPPLY NOTES

- WATER SUPPLY PIPE DIMENSIONS AND CLASSES
- 100 & 150 DIAMETER LINES- uPVC CLASS 16
 - SERVICE CONDUITS POSITIONS AND ROAD CROSSINGS, HAVE BEEN SURVEYED AT THE LOCATIONS INDICATED BY THE CONTRACTOR.

319597.03
7357256.35
MGA Zone 56

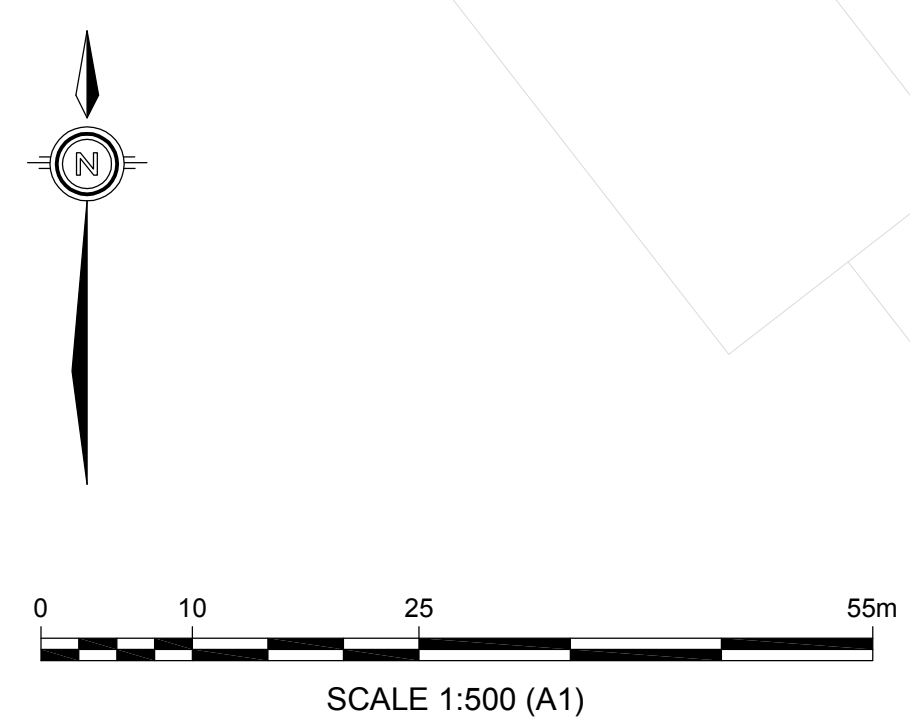

Sheet 1

Sheet 1