

CSG
 capricorn_survey_group
 4/32 Chapple Street
 POBox 490 Gladstone QLD
 4680 T 07 4972 9144 F 07
 4972 1885
 gladstone@capricsurvey.com.au
 A.B.N 59 419 394 233

PRINCIPAL
 Peet No 112
 Pty Ltd

PROJECT
 AS CONSTRUCTED
 INFORMATION
 VANTAGE ESTATE
 STAGE 2
 Sheet 1 of 2
Electrical

REAL PROPERTY DESCRIPTION

Lot No: 8-42,72-79,504,905
 Plan: SP233801
 Map Ref.: 9150-32114
 Parish: Auckland
 County: Clinton
 L.A.: Gladstone R. C.
 Locality: New Auckland

REVISIONS	DATE	INTS
A- Original Issue	20/2/11	DES
B- Turrets added	5/05/11	DES

FILE REF:	3353
VERSION:	63
DATA DISK:	GX
DATE:	4-05-11
FILE REF:	03353-38
DATA DISK:	Server
DATE:	5-05-11

SURVEYED:	CSG
DRAWN:	D.E.S.
QUALITY CH.D.	
DATE:	4-05-2011

DRAFTING	
DATE:	4-05-11
FILE REF:	03353-38
DATA DISK:	Server
DATE:	5-05-11

DATUM	
HORIZONTAL	MGA Zone 56
VERTICAL	AHD

SCALE	1:500@A1
--------------	----------




AUTHORISED BY		DATE	
----------------------	--	-------------	--

DIRECTOR		REV.	
-----------------	--	-------------	--

02987-63- Elect B

This information, as supplied by Capricorn Survey Group, is an accurate representation of the works as constructed and the information is suitable for use by Council and others.
 Signed: [Signature] Date: 05-05-2011
 Registered Professional Engineer
 Name: Chris Green Registration No. 8777

- GENERAL NOTES**
- These plans have been prepared as an As Constructed drawing for the Gladstone Regional Council and should not be used for any other purpose.
 - All surface and underground information has been located by the electrical contractor and indicated to Capricorn Survey Group during and after construction.
 - As this plan is presented in digital computer format no alterations, amendments or additions to the plan. This note is an integral part of the plan.
 - Types and classes of underground services are as per engineering design drawings by Worley Parsons Pty Ltd unless noted otherwise.
 - Coordinate origin from Adopted origin coordinates MGA Zone 56
 PSMH7594 East 319612.40 North 735704.742
 PSMH7198 East 319608.91 North 735710.905
 - AHD D from PSMH545 with adopted level of RL 57.996

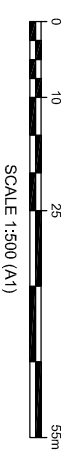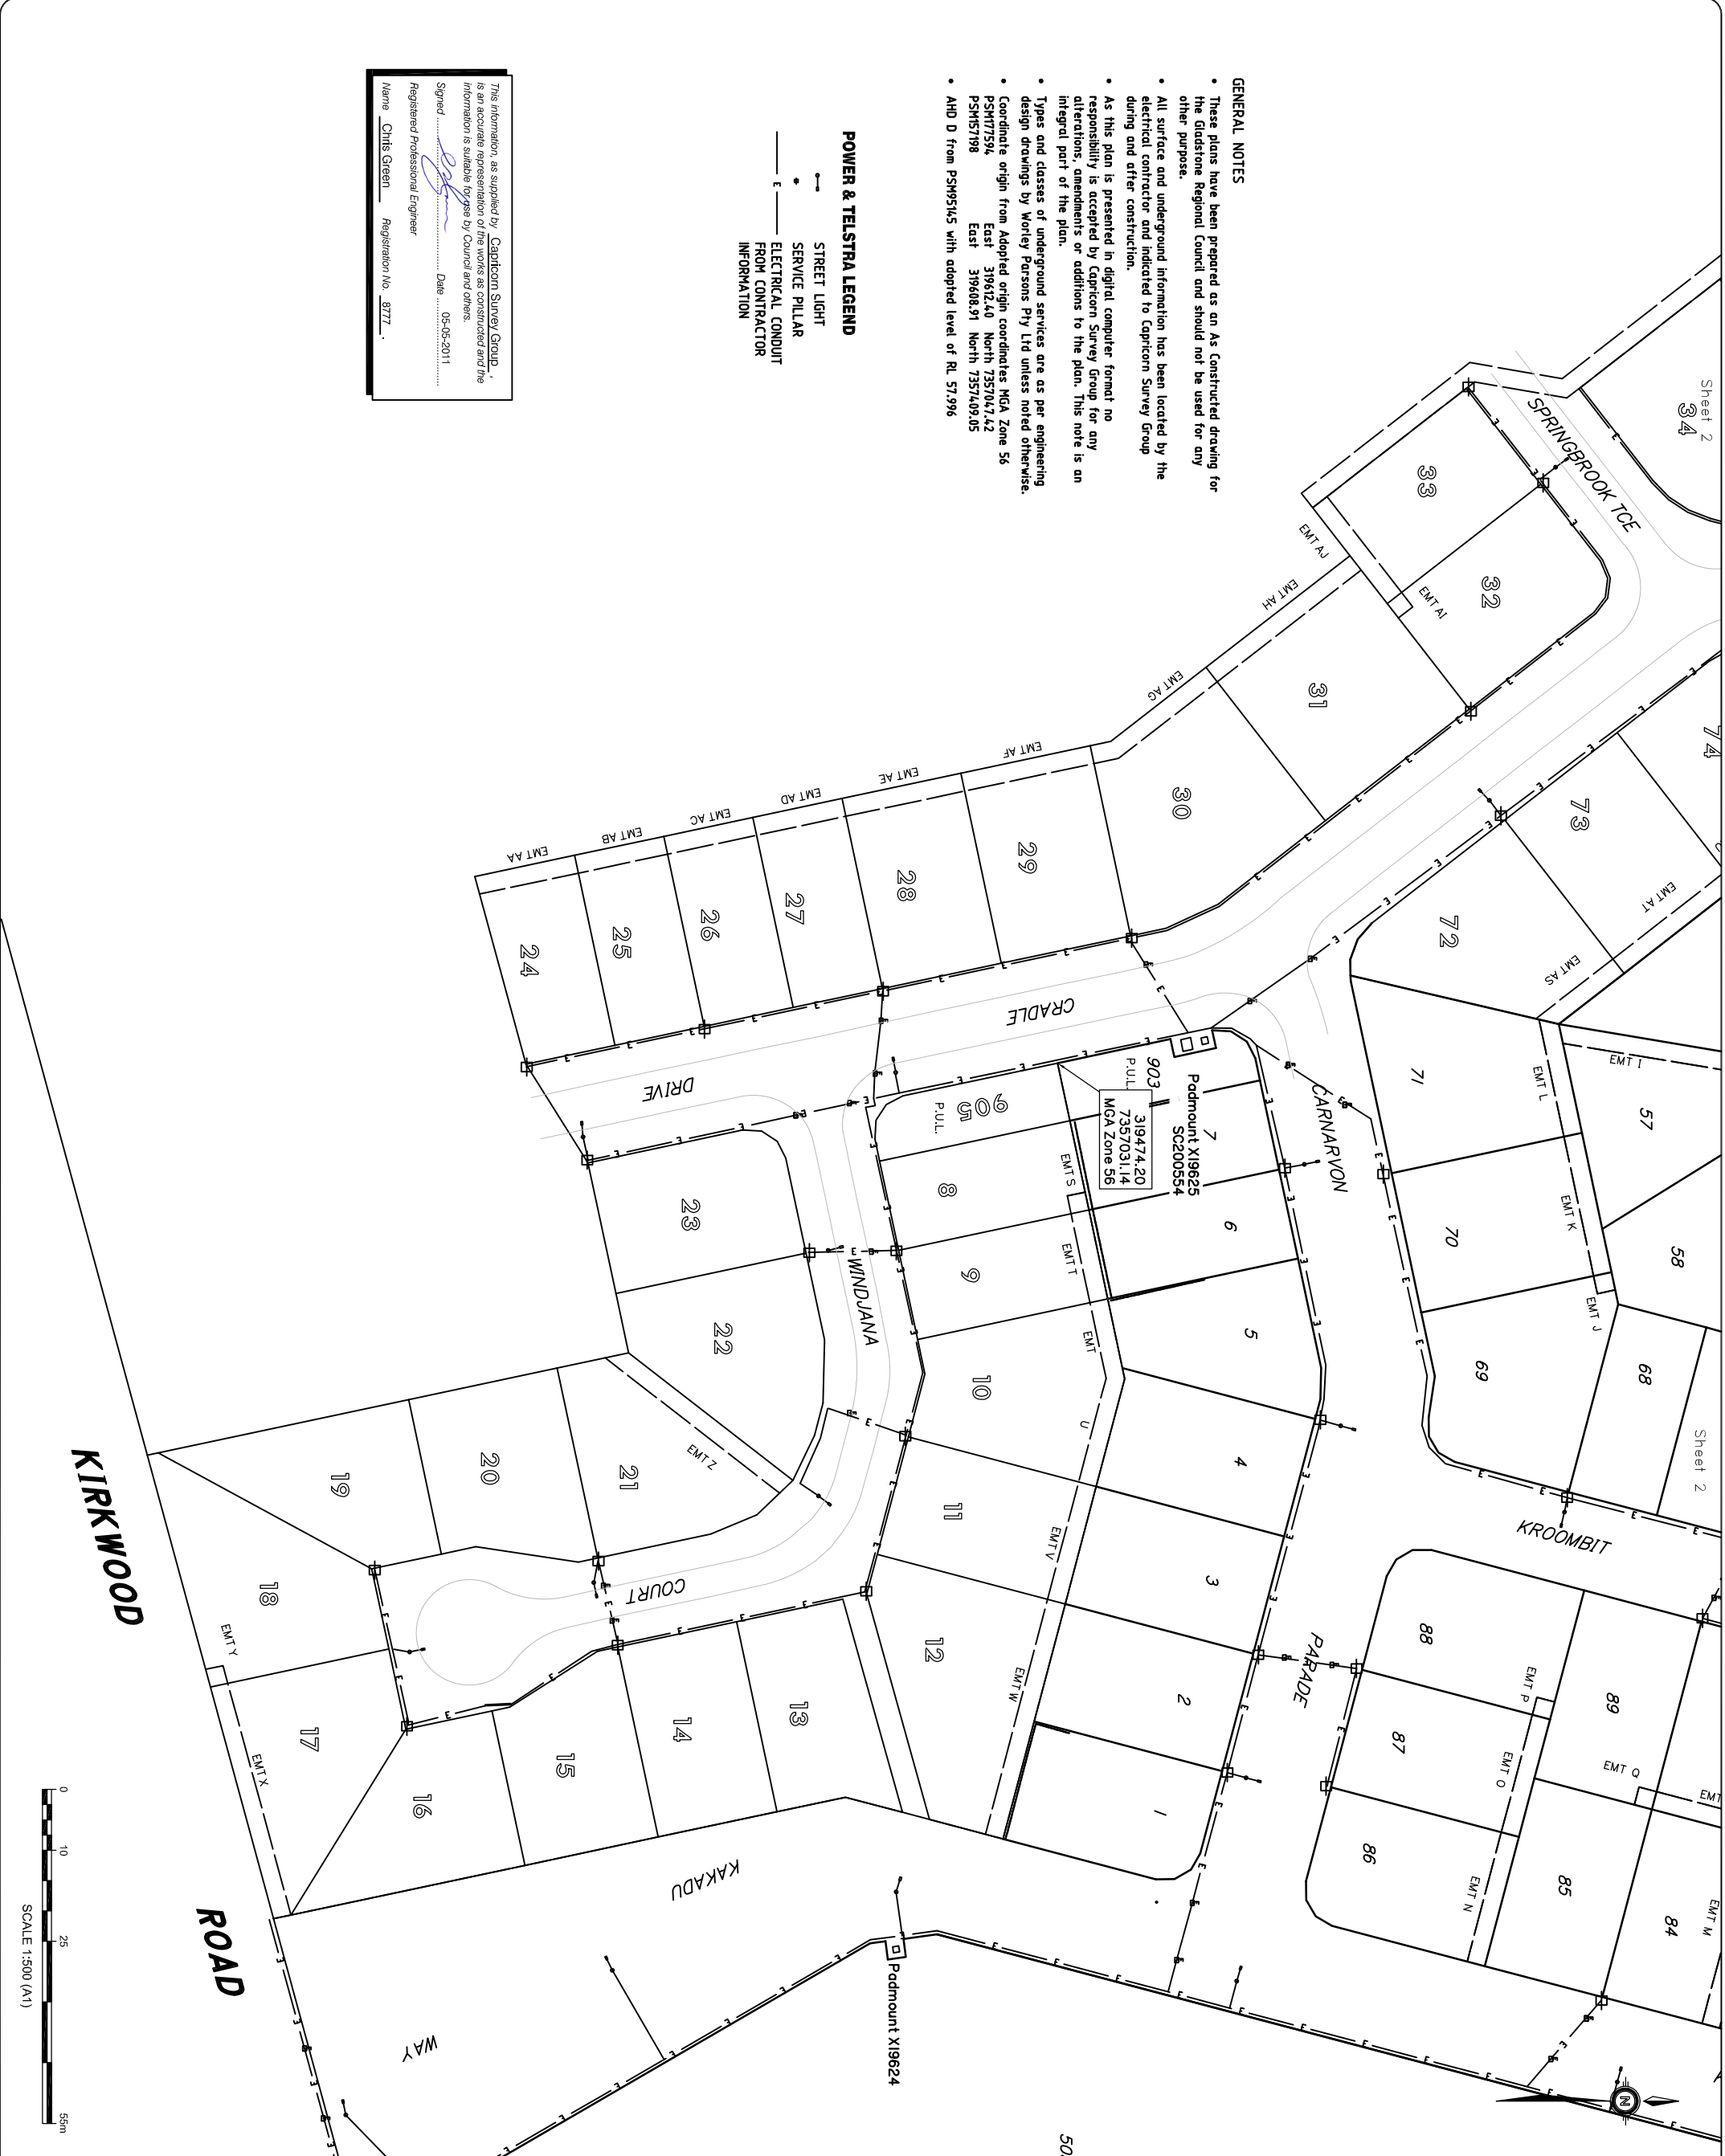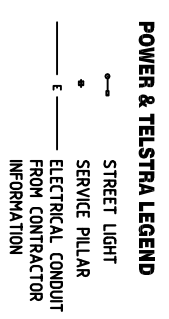




319362.44
7357305.56
MGA Zone 56


GENERAL NOTES

- These plans have been prepared as an As Constructed drawing for the Gladstone Regional Council and should not be used for any other purpose.
- All surface and underground information has been located by the electrical contractor and indicated to Capricorn Survey Group during and after construction.
- As this plan is presented in digital computer format no responsibility is accepted by Capricorn Survey Group for any alterations, amendments or additions to the plan. This note is an integral part of the plan.
- Types and classes of underground services are as per engineering design drawings by Worley Parsons Pty Ltd unless noted otherwise.
- Coordinate origin from Adopted origin coordinates MGA Zone 56
PSM77594 East 319612.40 North 7357047.42
PSM57198 East 319608.91 North 7357409.05
- AHD D from PSM95145 with adopted level of RL 57.996

POWER & TELSTRA LEGEND

- +— STREET LIGHT
- +— SERVICE PILLAR
- E— ELECTRICAL CONDUIT FROM CONTRACTOR INFORMATION

This information, as supplied by Capricorn Survey Group, is an accurate representation of the works as constructed and the information is suitable for use by Council and others.
Signed:  Date: 05-05-2011
Registered Professional Engineer
Name: Chris Green Registration No. 9777

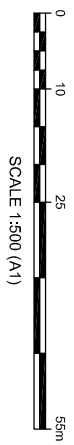

CSG
capricorn survey group
4/32 Chapple Street
POBox 490 Gladstone QLD
4680
T 07 4972 9144 F 07
4972 1885
gladstone@capricornsurvey.com.au
A.B.N 59 419 394 233

PRINCIPAL
Peet No 112
Pty Ltd

PROJECT
AS CONSTRUCTED
INFORMATION
VANTAGE ESTATE
STAGE 2
Sheet 2 of 2
Electrical

REAL PROPERTY DESCRIPTION

Lot No: 8-42,72-79,504,905
Plan: SP233801
Map Ref.: 9150-32114
Parish: Auckland
County: Clinton
L.A.: Gladstone R. C.
Locality: New Auckland

REVISIONS	DATE	INTS
A- Original Issue	20/2/11	D&S
B- Errors added	5/05/11	D&S

FILE REF:	3353
VERSION:	63
DATA DISK:	GX
DATE:	4-05-11
FILE REF:	03353-38
DATA DISK:	Server
DATE:	5-05-11

SOURCE DATA
DRAFTING DATE: 5-05-11
SURVEYED: CSG
DRAWN: D.E.S.
QUALITY CH D:
DATE: 4-05-2011

DATUM
HORIZONTAL: MGA Zone 56
VERTICAL: AHD

SCALE: 1:500 @ A1
AUTHORISED BY: _____ DATE: _____

DIRECTOR	REV.
03353-38 Elect B	